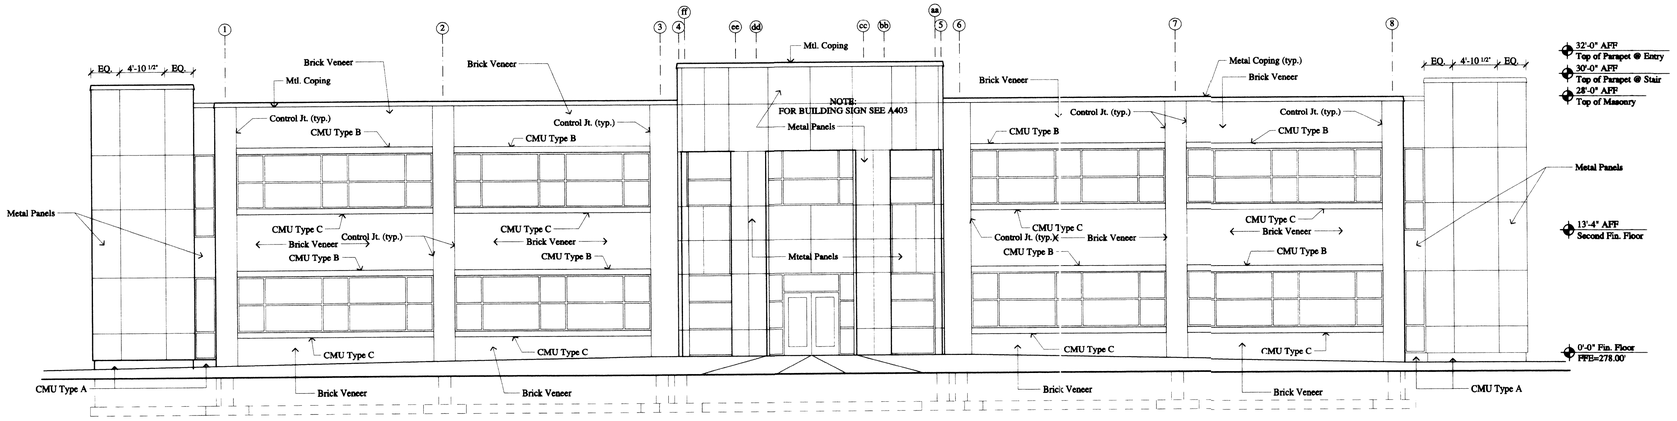

A2 / A201 East Elevation
1/8" = 1'-0"

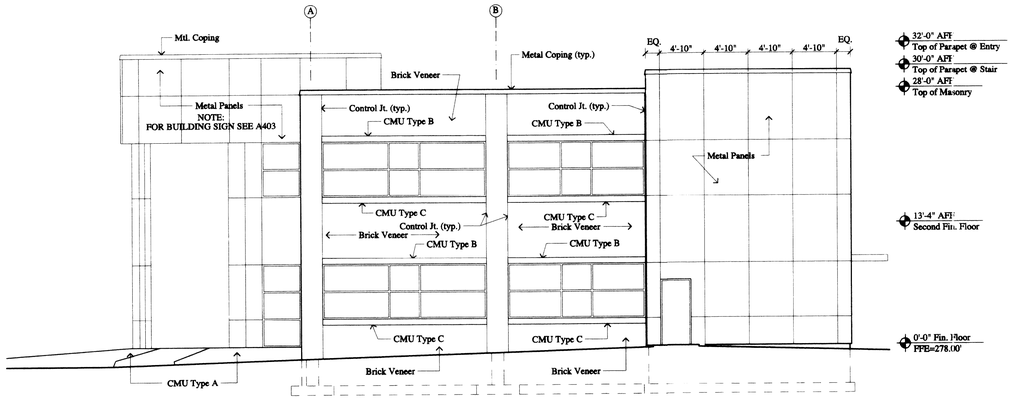

B1 / A201 North Elevation
1/8" = 1'-0"

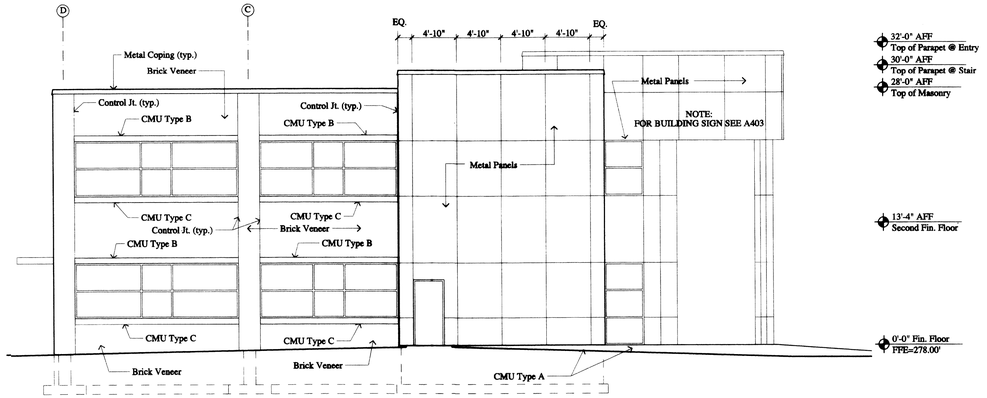

B3 / A201 South Elevation
1/8" = 1'-0"

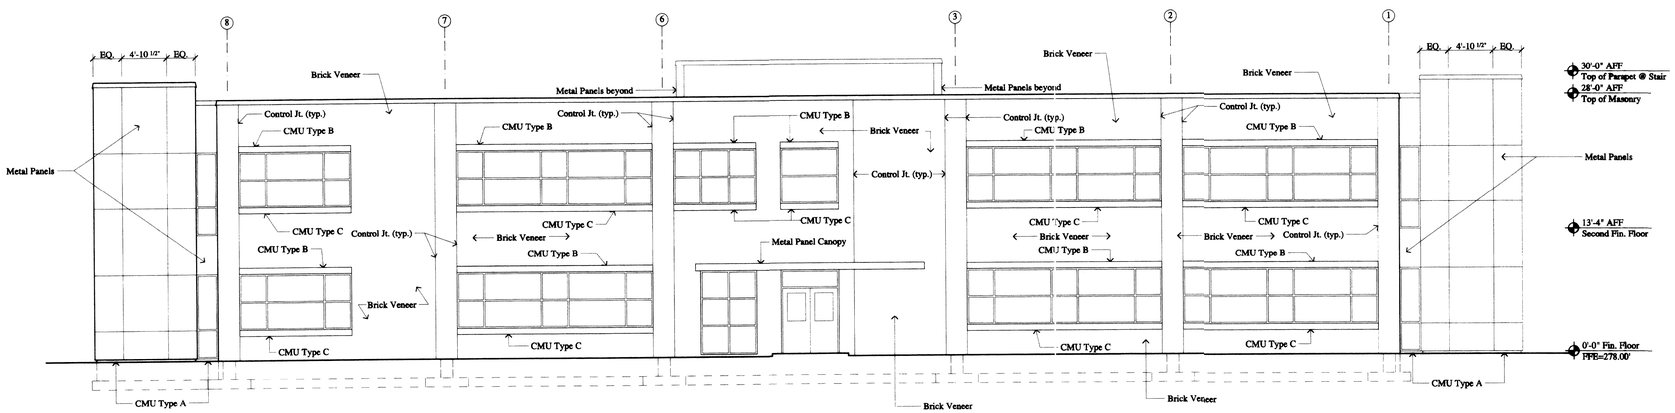

C2 / A201 West Elevation
1/8" = 1'-0"

RECORD DRAWINGS

REVISIONS

No.	Remarks	Date

MARK E. WILLIARD REGISTERED ARCHITECT NORTH CAROLINA RALEIGH N.C.
1-25-01

MARK WILLIARD AND ASSOCIATES, P.A. REGISTERED ARCHITECTURAL CORPORATION CERT. NO. 50684 NORTH CAROLINA RALEIGH, N.C.

Mark Williard & Associates, P.A.
728 North Blount Street
Raleigh, North Carolina 27604
Tel.: 919 834-0620 Fax: 919 834-2149

City of Raleigh
Office Building for Raleigh Business & Technology Center
900 South Wilmington Street
Raleigh, North Carolina 27601

Drawing Title: Elevations

Sheet No. A201 of

Date: 15 January 2001